LABOR AND MATERIALS

1	Copper ~~Lead~~	Connection	3/4	$ 2.90
1	Curb { Clock / ~~Valve T. S. & V.~~ }		3/4 in.	$ 3.60
1	Service box ~~Old returned~~	{ ~~Short 3½X4½~~ / Long 4½X5½ / ~~Buff or Rdway~~ }		$ 5.80
13 Ft.	3/4 in.	{ Copper / Galv. Iron / Cast Iron }	Pipe at 35	$ 4.65
	Nipples	in. at		$
	Bushings	to in. at		$
	Red'g Inc'g Couplings	to in. at		$
	Union	in. at		$
	Meter	in. at		$
	Lead Joints at			$
	Compound Joints at			$
	Hrs. Foreman at			$
	Hrs. Chauffeur at			$
4	Hrs. Tapper at	91		$ 3.64
12	Hrs. Labor at	80		$ 9.60
	Hrs. Labor at			$
	Hrs. Compressor at			$
	Compensation Ins.			$ .29
	Trucking			$ 1.00
	Builders Use of Water			$ 5.80
Tap by Municipal				$
				$
				$
				$

$ 37.18

159/147

St. 10
Pl.
Ave. No. 4

Cunningham

Name of Owner

~~Wm.~~ Caswell

Labor and Mat'l. Report Nov 28 19 47

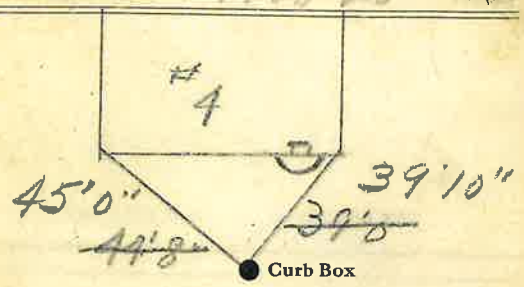

6 Main — Elev. of Main at tap 6

Gate at ● — ● Gate at

● Curb Box

LSM-5C-6-1-45