LABOR AND MATERIALS

1	Copper ~~Lead~~ Connection 3/4		$ 2.80
1	Curb { Clock ~~Valve~~ ~~T. S. & V.~~ } 3/4 in.		$ 3.60
1	Service box Old returned { Short 3½X4½ ~~Long 4½X5½~~ ~~Buff or Rdway~~ }		$ 5.80
1 FT of COPPER - PER CURT.			
~~12~~	Ft. 3/4 in. { Copper ~~Galv. Iron~~ ~~Cast Iron~~ } Pipe at 35		$ 4.20
	Nipples in. at		$
	Bushings to in. at		$
	Red'g Inc'g } Couplings to in. at		$
	Union in. at		$
	Meter in. at		$
	Lead Joints at		$
	Compound Joints at		$
2	Hrs. ~~Foreman at~~ WMM①	1.01	$ 2.02
2	Hrs. ~~Chauffeur at~~ WMM2	.91	$ 1.82
	Hrs. Tapper at		$
4	Hrs. Labor at	.80	$ 3.20
	Hrs. Labor at		$
	Hrs. Compressor at		$
	Compensation Ins.		$ 16
	Trucking		$ 1.00
	Builders Use of Water		$ —
Tanly Miller			$
			$
			$
			$
			$ 24.60

116 J 47

~~St.~~
~~Pl.~~
Daywin Ave. No. 2

Name of Owner
EA Bailey

Labor and Mat'l. Report July 15 1947

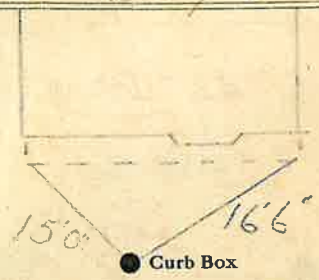

4 Main

Elev. of Main at tap 4

Gate at ● ● Gate at

● Curb Box

LSM-5C-6-1-45 to be charge