LABOR AND MATERIALS

1 Copper / ~~Lead~~ } Connection 3/4 $ 1.31

1 Curb { Cock / Valve / T. S. & V. } 3/4 in. $ 1.75

1 Service Box Old returned { Short 3½x4½ / Long 4½x5½ / Buff. or Rdway } $ 1.60

26 Ft. 3/4 in. { Copper / Galv Iron / Cast Iron } Pipe at 18 $ 4.68

____ Nipples ____ in. at ____ $ ____

____ Bushings ____ to ____ in. at ____ $ ____

____ Red'g / Inc'g } Couplings ____ to ____ in. at ____ $ ____

____ Union ____ in. at ____ $ ____

____ Meter ____ in. at ____ $ ____

____ Lead Joints at ____ $ ____

____ Leadite Joints at ____ $ ____

____ Hrs. Foreman at ____ $ ____

5 Hrs. Chauffeur at 62½ $ 3.13

8 Hrs. Tapper at " $ 5.—

10 Hrs. Labor at 45 $ 4.50

____ Hrs. Labor at ____ $ ____

____ Hrs. Compressor at ____ $ ____

____ Compensation Ins. ____ $ .39

____ Trucking ____ $ 1.—

____ Builders Use of Water Patch $ 5.—

Tap by Hessel $ ____

$ ____

$ ____

$ ____

$ 28.36

8 - - 1940

St.
~~Pl~~

Division Ave. No. 15

Name of Owner

MEGilligan

Labor and Mat'l. Report Apr 22 1940

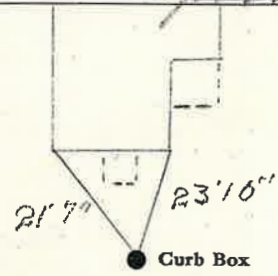

1 Main

Elev. of Main at tap 5

Gate at ● ● Gate at

TAX ID # 309.27-3-2

● Curb Box

old dó be Dug up. H