LABOR AND MATERIALS

1	Copper ~~Lead~~ Connection 3/4	$ 1.35
1	Curb { Cock Valve ~~T. S. & V.~~ } 3/4 in.	$ 1.80
1	Service Box Old returned { ~~Short 3½x4½~~ Long 4½x5½ ~~Buffor Rdway~~ }	$ 1.70
12 Ft. 3/4 in.	{ Copper ~~Galv Iron~~ ~~Cast Iron~~ } Pipe at 18	$ 2.16
	Nipples ..... in. at	$
	Bushings ..... to ..... in. at	$
	Red'g Inc'g Couplings ..... to ..... in. at	$
	Union ..... in. at	$
	Meter ..... in. at	$
	Lead Joints at	$
	Leadite Joints at	$
	Hrs. Foreman at	$
1	Hrs. Chauffeur at 62½	$ .63
2 1/2	Hrs. Tapper at	$ 1.56
9 1/2	Hrs. Labor at 45	$ 4.28
	Hrs. Labor at	$
	Hrs. Compressor at	$
	Compensation Ins.	$ .20
	Trucking	$ 1.—
	Builders Use of Water Buffalo Tavern Tapped by Hesse	$ —
		$
		$
		$
		$ 14.68

1 2 7 1941

~~St.~~ ~~Pl.~~ Ave. No. 7

Diz

Name of Owner

Joe Regan

Labor and Mat'l. Report Oct 14 1941

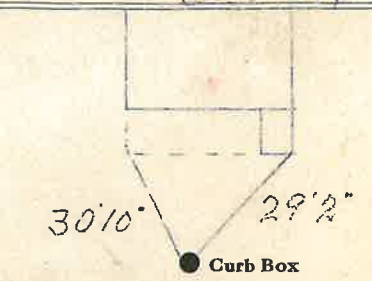

4 Main

Elev. of Main at tap 5

Gate at ●

● Gate at

● Curb Box