LABOR AND MATERIALS

1	Copper / ~~Lead~~ } Connection 3/4	$ 1.35
1	Curb { Cock / ~~Valve~~ / ~~T. S. & V.~~ } 3/4 in.	$ 1.80
1	Service Box Old returned { Short 3½x4½ / ~~Long 4½x5½~~ / ~~Buff or Rdway~~ }	$ 1.70
30	Ft. 3/4 in. { Copper / ~~Galv Iron~~ / ~~Cast Iron~~ } Pipe at	$ 5.40
	Nipples ... in. at	$
	Bushings ... to ... in. at	$
	Red'g / Inc'g } Couplings ... to ... in. at	$
	Union ... in. at	$
	Meter ... in. at	$
	Lead Joints at	$
	Leadite Joints at	$
	Hrs. Foreman at	$
3¼	Hrs. Chauffeur at 62½	$ 2.03
6¼	Hrs. Tapper at	$ 3.90
23¼	Hrs. Labor at 45	$ 10.46
	Hrs. Labor at	$
1	Hrs. Compressor at	$ .63
	Compensation Ins.	$ .50
	Trucking	$ 1.—
	Builders Use of Water Before Paving	$ —
	Tap by Hesser	$
		$
		$
		$
		$ 28.77

[illegible] 3 7 1941

~~St.~~ ~~Pl.~~ Ave. No. 28

DIX

Name of Owner

Burke Lot

Labor and Mat'l. Report Oct 10 1941

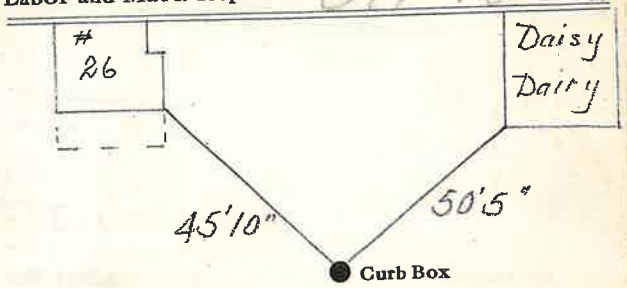

6" Main

Elev. of Main at tap 5'

Gate at

Gate at

Curb Box