LABOR AND MATERIALS

1	Copper ~~Lead~~ Connection	3/4	$ 1.35
1	Curb { Cock ~~Valve~~ ~~T. S. & V.~~ }	3/4 in.	$ 1.80
1	Service Box Old returned { ~~Short 3½x4½~~ Long 4⅝x5⅛ ~~Buff or Rdway~~ }		$ 1.70
13	Ft. 3/4 in. { Copper ~~Galv Iron~~ ~~Cast Iron~~ }	Pipe at 18	$ 2.34
	Nipples	in. at	$
	Bushings	to in. at	$
	Red'g Inc'g } Couplings	to in. at	$
	Union	in. at	$
	Meter	in. at	$
	Lead Joints at		$
	Leadite Joints at		$
	Hrs. Foreman at		$
1	Hrs. Chauffeur at	62½	$ .63
2½	Hrs. Tapper at	"	$ 1.56
9½	Hrs. Labor at	"	$ 4.28
	Hrs. Labor at		$
	Hrs. Compressor at		$
	Compensation Ins.		$ .20
	Trucking		$ 1.—
	Builders Use of Water Before Paving		$ —
	Tapping Hessel		$
			$
			$
			$
			$ 14.86

1 3 8 1941

St.
Pl.
Ave. No. 29

DIX

Name of Owner

Nora Herlihy

Labor and Mat'l. Report Oct 10 1941

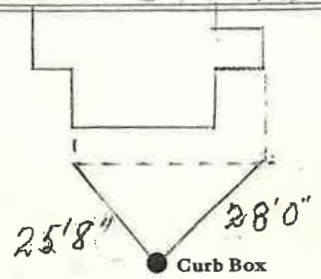

6" Main

Elev. of Main at tap 5'

Gate at ● ● Gate at

TAX ID # 303.13-17-14

● Curb Box