LABOR AND MATERIALS

1 Copper Lead	Connection 2"	$ 10.95
1 Curb	Cock ~~Valve~~ ~~T. S. & V.~~ 2" in.	$ 10.67
1 Service Box	~~Old returned~~ ~~Short 3½x4½~~ ~~Long 4½x5½~~ ~~Buff. or Rdway~~	$ N C.
32 Ft. 2 in.	Copper ~~Galv. Iron~~ ~~Cast Iron~~ Pipe at ~~45~~	$ 14.40
------ Nipples	------ in. at	$ ------
------ Bushings	------ to ------ in. at	$ ------
------ Red'g Inc'g Couplings	------ to ------ in. at	$ ------
------ Union	------ in. at	$ ------
------ Meter	------ in. at	$ ------
------ Lead Joints at		$ ------
------ Leadite Joints at		$ ------
------ Hrs. Foreman at		$ ------
11 Hrs. Chauffeur at	62½	$ 6.88
2 Hrs. Tapper at		$ 1.25
37 Hrs. Labor at	.45	$ 16.67
------ Hrs. Labor at		$ ------
------ Hrs. Compressor at		$ ------
------ Compensation Ins.		$ .76
4 Trucking	.75	$ 3.00
------ Builders Use of Water	Patch -	$ 5.00
Typ'y Miller		$ ------
OH + Supervision		$ 5.00
		$ ------
		$ ------
		$ 74.56

Less -2-1" Conn. 47.00

27.56

1 4 9 - 1938

~~St.~~ ~~Pl.~~ Dix Ave. No. 32434

Name of Owner

Daisy Dairy

Labor and Mat'l. Report Aug 2 1938

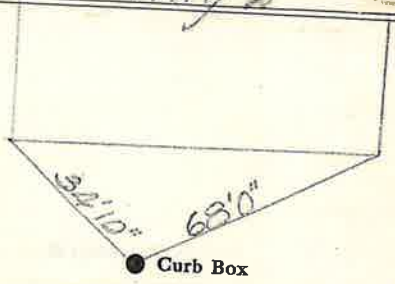

6" Main

1" Elev. of Main at tap 4½

Gate at

Gate at

Curb Box

old Shut off

145