LABOR AND MATERIALS

1	Copper Lead — Connection	3/4	$ 1.79
1	Curb — Clock Valve T. S. & V.	3/4 in.	$ 2.61
1	Service box Old returned — Short 3½X4½ Long 4½X5½ Buff or Rdway		$ 1.82
9	Ft. 3/4 in. — Copper ~~Galv. Iron~~ ~~Cast Iron~~	Pipe at 23	$ 2.07
	Nipples	in. at	$
	Bushings	to in. at	$
	Red'g Inc'g Couplings	to in. at	$
	Union	in. at	$
	Meter	in. at	$
	Lead Joints at		$
	Compound Joints at		$
	Hrs. Foreman at		$
6	Hrs. Chauffeur at	.75	$ 4.50
	Hrs. Tapper at		$
14	Hrs. Labor at	.65	$ 9.10
	Hrs. Labor at		$
	Hrs. Compressor at	87½	$ .88
	Compensation Ins.		$ .37
	Trucking		$ 1.00
	Builders Use of Water		$ 5.00
	Tap by Watrous Co		$
			$
			$
			$
			$ 29.14

✓

40 - 46

✓

Dix Ave — St. Pl. Ave. No. 117

Name of Owner

Schoenberger

Labor and Mat'l. Report July 8 1946

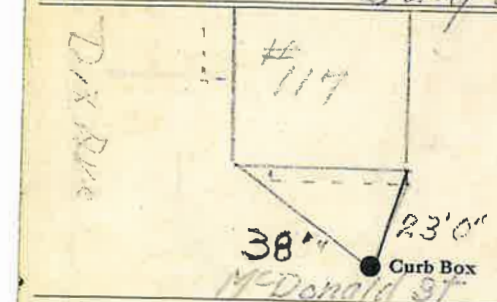

8"-1975

4 Main — Elev. of Main at tap 6

Gate at ● — ● Gate at

TA ID # 303.14-2-13.2

● Curb Box

LSM-5C-6-1-45 This tap on McDonald St.