LABOR AND MATERIALS

1 ~~Copper~~ ~~Lead~~ } Connection 3/4" $

1 Curb { ~~Cock~~ ~~Valve~~ ~~T. S. & V.~~ } 3/4 in. $

1 Service box { ~~Short 3½ x 4½~~ ~~Long 4½ x 5½~~ ~~Buff or Rdway~~ } $

~~Old returned~~

12 Ft. 3/4 in. { ~~Copper~~ ~~C. I.~~ ~~C. I.~~ } Pipe at $

Nipples in. at $

Bushings to in. at $

Red'g / Inc'g Coupl'gs to in. at $

Union in. at $

Meter in. at $

Lead Joints at $

Compound Joints at $

Maintenance Foreman $

Hrs. Water Maint. Man—1 at $

Hrs. Water Maint. Man—2 at $

Hrs. Garage Foreman at $

Hrs. Labor— at $

Hrs. Compressor at $

Compensation Ins. at $ per C $

Trucking $

Pav't Patch $

Tap by Gifford & Co. 7-20-61. $

$

$

O'head $

$

Elizabeth St. ~~Pl.~~ ~~Ave.~~ No. 2

Name of Owner IRENE Fitz Gerald

Harry Gardner.

Labor and Mat'l. Report July 20 1961.

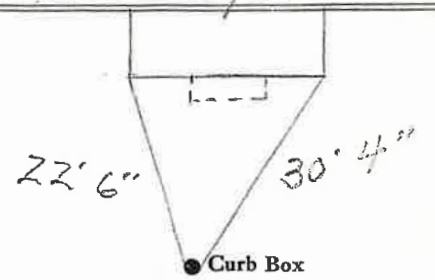

6" Main Elev. of Main at tap 5"

Gate at ● ● Gate at

TAX ID # 309.27-1-3

● Curb Box

LSM—5C—3-10-61