LABOR AND MATERIALS

1 Copper ~~Lead~~	Connection 3/4	$ 1.31
1 Curb { Cock ~~Valve~~ ~~T. S. & V.~~ }	3/4 in.	$ 1.75
1 Service Box Old returned { ~~Short 3½x4½~~ Long 4½x5½ ~~Buff. or Rdway~~ }		$ 1.60
10 Ft. 3/4 in. { Copper ~~Galv Iron~~ ~~Cast Iron~~ }	Pipe at 18	$ 1.80
____ Nipples	____ in. at	$ ____
____ Bushings	____ to ____ in. at	$ ____
____ Red'g Inc'g	Couplings ____ to ____ in. at	$ ____
____ Union	____ in. at	$ ____
____ Meter	____ in. at	$ ____
____ Lead Joints at		$ ____
____ Leadite Joints at		$ ____
____ Hrs. Foreman at		$ ____
2½ Hrs. Chauffeur at	62½	$ 1.56
1 Hrs. Tapper at		$ .63
9 Hrs. Labor at	45	$ 4.05
____ Hrs. Labor at		$ ____
____ Hrs. Compressor at		$ ____
____ Compensation Ins.		$ .19
____ Trucking		$ 1.—
____ Builders Use of Water		$ ____
Tap by Miller		$ ____
		$ ____
		$ ____
		$ ____
		$ 13.89

2 2 - - 1940

St.
Pl.
Elvin Ave. No. 15

Name of Owner

Pruyn & Manzies

Labor and Mat'l. Report June 27 19 40

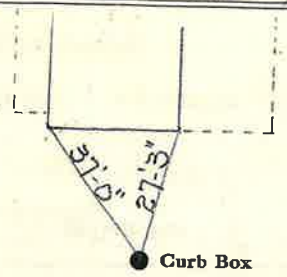

6" Main

Elev. of Main at tap 6'

Gate at ● ● Gate at

● Curb Box