LABOR AND MATERIALS

1	Copper ~~Lead~~ Connection 3/4	$ 1.31
1	Curb {Cock ~~Valve~~ ~~T. S. & V.~~} 3/4 in.	$ 1.75
1	Service Box Old returned {Short 3½x4½ Long 4½x5½ ~~Buff. or Rdway~~}	$ 1.60
12	Ft. 3/4 in. {Copper ~~Galv. Iron~~ ~~Cast Iron~~} Pipe at 18	$ 2.16
	Nipples ____ in. at	$
	Bushings ____ to ____ in. at	$
	Red'g Inc'g Couplings ____ to ____ in. at	$
	Union ____ in. at	$
	Meter ____ in. at	$
	Lead Joints at	$
	Leadite Joints at	$
	Hrs. Foreman at	$
3	Hrs. Chauffeur at 62½	$ 1.87
1	Hrs. Tapper at	$ .63
10	Hrs. Labor at 45	$ 4.50
	Hrs. Labor at	$
	Hrs. Compressor at	$
	Compensation Ins.	$ .22
	Trucking	$ 1.—
	Builders Use of Water	$
	Tapped Mains	$
		$
		$
		$
		$ 15.04

7 8 -- 1940

St. ~~Pl.~~ Ave. No. 71

Elm

Name of Owner

Goffney

Labor and Mat'l. Report 2 June 19 1940

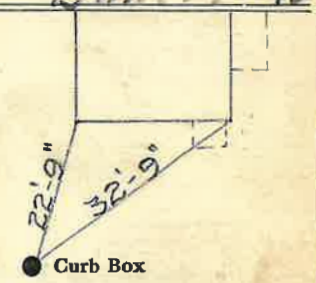

6" Main

Elev. of Main at tap 6'

Gate at ● ● Gate at

TAX ID # 302.20-21-10

● Curb Box