LABOR AND MATERIALS

1	Copper ~~Lead~~ Connection 3/4	$ 1.31
1	Curb { Cock ~~Valve~~ ~~T. S. & V.~~ } 3/4 in.	$ 1.75
1	Service Box Old returned { ~~Short 3½x4½~~ Long 4½x5½ ~~Buff. or Rdway~~ }	$ 1.60
24 Ft. 3/4 in.	{ ~~Copper~~ ~~Galv Iron~~ ~~Cast Iron~~ } Pipe at 18	$ 4.32
	Nipples ____ in. at	$
	Bushings ____ to ____ in. at	$
	Red'g Inc'g Couplings ____ to ____ in. at	$
	Union ____ in. at	$
	Meter ____ in. at	$
	Lead Joints at	$
	Leadite Joints at	$
	Hrs. Foreman at	$
6	Hrs. Chauffeur at 62½	$ 3.75
24½	Hrs. Tapper at 7	$ 1.56
22	Hrs. Labor at 45	$ 9.90
	Hrs. Labor at	$
	Hrs. Compressor at	$
	Compensation Ins.	$ .47
	Trucking	$ 1.—
	Builders Use of Water	$
	Tapby Miller	$
		$
		$
		$
		$25.66

8 0 - - 1940

St. ~~Pl.~~ Elm Ave. No. 74

Name of Owner

Donahue

Labor and Mat'l. Report June 19 1940

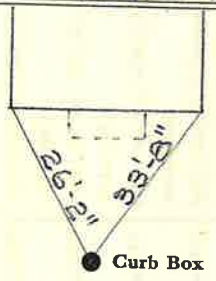

6" Main

Elev. of Main at tap 6'

Gate at ● ● Gate at

● Curb Box