LABOR AND MATERIALS

1	Copper ~~Lead~~ Connection	3/4"	$ 1.31
1	Curb { Cock ~~Valve~~ ~~T. S. & Y.~~ }	3/4 in.	$ 1.75
1	Service Box ~~Old returned~~ { Short 3½x4½ ~~Long 4½x5½~~ ~~Buff. or Rdway~~ }		$ 1.60
28 Ft.	3/4 in. { Copper ~~Galv. Iron~~ ~~Cast Iron~~ }	Pipe at 18	$ 5.04
	Nipples ____ in. at		$
	Bushings ____ to ____ in. at		$
	Red'g / Inc'g Couplings ____ to ____ in. at		$
	Union ____ in. at		$
	Meter ____ in. at		$
	Lead Joints at		$
	Leadite Joints at		$
	Hrs. Foreman at		$
2¼	Hrs. Chauffeur at 62½		$ 1.41
4¾	Hrs. Tapper at "		$ 2.97
19	Hrs. Labor at 45		$ 8.55
	Hrs. Labor at		$
	Hrs. Compressor at		$
	Compensation Ins.		$ .40
	Trucking		$ 1.—
	Builders Use of Water to patch Before Paving		$
			$
			$
Tap by Neal			$
			$ 24.03

SEP 19 - 1940

REAR OF 215 SOUTH St.
~~Pl.~~
Fifth Ave. No. 1/2

Name of Owner

West

Labor and Mat'l. Report SEP 24 1940 19

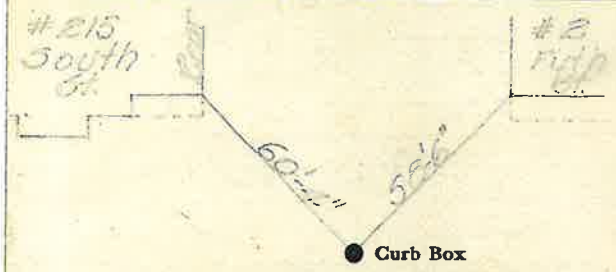

2" Main

Elev. of Main at tap 5'

Gate at ● ● Gate at

● Curb Box

Lot Tap