LABOR AND MATERIALS

1	Copper ~~Lead~~ Connection 3/4	$ 1.31
1	Curb Cock ~~Mueller~~ ~~Ford~~ 3/4 in.	$ 1.75
1	Service Box Old returned Short 3½x4½ ~~Long 4½x5½~~ ~~Buff or Rdway~~	$ 1.60
37 Ft. 3/4 in.	Copper ~~Galv Iron~~ ~~Cast Iron~~ Pipe at 18	$ 6.66
	Nipples ____ in. at	$
	Bushings ____ to ____ in. at	$
	Red'g Inc'g Couplings ____ to ____ in. at	$
	Union ____ in. at	$
	Meter ____ in. at	$
	Lead Joints at	$
	Leadite Joints at	$
	Hrs. Foreman at	$
7	Hrs. Chauffeur at 62½	$ 4.32
1	Hrs. Tapper at	$ .63
15	Hrs. Labor at 45	$ 6.75
	Hrs. Labor at	$
	Hrs. Compressor at	$
	Compensation Ins.	$ .36
	Trucking	$ 1.—
	Builders Use of Water Patch	$ 5.—
	Taphy Penor	$
		$
		$
		$
		$ 29.38

8 1 - - 1946

St. Pl. Fifth Ave. No. 10

Name of Owner

Willard

Labor and Mat'l. Report June 10 19 40

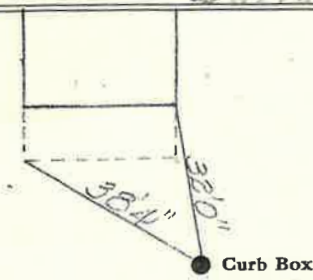

1" Main

Elev. of Main at tap 5½'

Gate at ● ● Gate at

TAX ID # 309.12-15-8

● Curb Box