LABOR AND MATERIALS

1	Copper ~~Lead~~ Connection 3/4"	$ 1.31
1	Curb { Cock ~~Valve~~ ~~T. S. & V.~~ } 3/4 in.	$ 1.75
1	Service Box ~~Old returned~~ { Short 3½x4½ ~~Long 4½x5½~~ ~~Buff. or Rdwy~~ }	$ 1.60
7	Ft. 3/4 in. { Copper ~~Galv. Iron~~ ~~Cast Iron~~ } Pipe at 18	$ 1.26
	Nipples ____ in. at	$
	Bushings ____ to ____ in. at	$
	Red'g Inc'g Couplings ____ to ____ in. at	$
	Union ____ in. at	$
	Meter ____ in. at	$
	Lead Joints at	$
	Leadite Joints at	$
	Hrs. Foreman at	$
½	Hrs. Chauffeur at 62½	$ .31
1	Hrs. Tapper at	$ .63
4½	Hrs. Labor at 45	$ 2.03
	Hrs. Labor at	$
	Hrs. Compressor at	$
	Compensation Ins.	$ .10
	Trucking	$ 1.—
	Builders Use of Water no patch	$
		$
		$
	Tap by Hessel	$
		$ 9.99

1 2 3 - 1940

St.
~~Pl.~~
Fifth Ave. No. 11

Name of Owner

Kingsley

Labor and Mat'l. Report SEP 2 4 1940 19

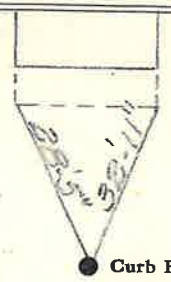

1" Main

Elev. of Main at tap 5'

Gate at ● ● Gate at

● Curb Box

Old tap shut off.

TR