LABOR AND MATERIALS

1	Copper ~~Lead~~ Connection	3/4"	$ 1.31
1	Curb { Cock / ~~Valve~~ / ~~T. S. & V.~~ }	3/4 in.	$ 1.75
1	Service Box ~~Old returned~~ { Short 3½x4½ / ~~Long 4½x5½~~ / ~~Buff. or Rdway~~ }		$ 1.60
28 Ft.	3/4 in. { Copper / ~~Galv Iron~~ / ~~Cast Iron~~ } Pipe at	18	$ 5.04
	Nipples ____ in. at		$
	Bushings ____ to ____ in. at		$
	Red'g / Inc'g Couplings ____ to ____ in. at		$
	Union ____ in. at		$
	Meter ____ in. at		$
	Lead Joints at		$
	Leadite Joints at		$
	Hrs. Foreman at		$
2¼	Hrs. Chauffeur at	62½	$ 1.41
4¾	Hrs. Tapper at		$ 2.97
19	Hrs. Labor at	45	$ 8.55
	Hrs. Labor at		$
	Hrs. Compressor at		$
	Compensation Ins.		$ .40
	Trucking		$ 1.—
	Builders Use of Water		$
old Shut off			$
			$
Tap by Hasel			$
			$ 24.03

12 4 - 1940

St. ~~Pl.~~ Fifth Ave. No. 22

Name of Owner

Wilsey

Labor and Mat'l. Report SEP 2 4 1940 19

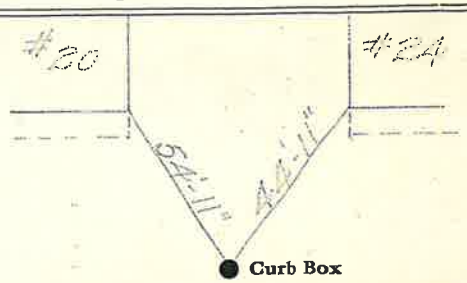

1" Main

Elev. of Main at tap 5'

Gate at ●

● Gate at

● Curb Box

Lot Tap

Off 0