LABOR AND MATERIALS

1	Copper ~~Lead~~ Connection	3/4"	$ 1.31
1	Curb { Cock ~~Valve~~ ~~T. S. & V.~~ }	3/4 in.	$ 1.75
1	Service Box ~~Old returned~~ { Short 3½x4½ ~~Long 4½x5½~~ ~~Buff. or Rdway.~~ }		$ 1.60
8	Ft. 3/4 in. { Copper ~~Galv. Iron~~ ~~Cast Iron~~ } Pipe at 18		$ 1.44
	Nipples ____ in. at		$
	Bushings ____ to ____ in. at		$
	Red'g Inc'g Couplings ____ to ____ in. at		$
	Union ____ in. at		$
	Meter ____ in. at		$
	Lead Joints at		$
	Leadite Joints at		$
	Hrs. Foreman at		$
1/4	Hrs. Chauffeur at	62½	$ .31
1¼	Hrs. Tapper at		$ .94
5	Hrs. Labor at	45	$ 2.25
	Hrs. Labor at		$
	Hrs. Compressor at		$
	Compensation Ins.		$ .31
	Trucking		$ 1.—
	Builders Use of Water		$
			$
			$
Top by Hassel			$
			$ 10.72

I 2 7 - 1940

St.
~~Pl.~~
Ave. No. 27

Fifth

Name of Owner

Haight

Labor and Mat'l. Report SEP 2 4 1940 19

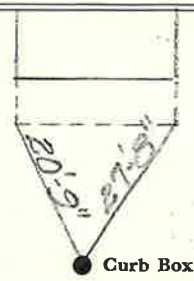

1" Main

Elev. of Main at tap 5'

Gate at ● ● Gate at

● Curb Box

Old tap shut off