LABOR AND MATERIALS

1 Copper ~~Lead~~ } Connection 3/4" $ 1.31

1 Curb { Cock / ~~Valve~~ / ~~T. S. & V.~~ } 3/4 in. $ 1.75

1 Service Box ~~Old returned~~ { Short 3½x4½ / ~~Long 4½x5½~~ / ~~Buff. or Rdway~~ } $ 1.60

28 Ft. 3/4 in. { Copper / ~~Galv Iron~~ / ~~Cast Iron~~ } Pipe at 18 $ 5.04

_____ Nipples _____ in. at _____ $ _____

_____ Bushings _____ to _____ in. at _____ $ _____

_____ Red'g / Inc'g } Couplings _____ to _____ in. at _____ $ _____

_____ Union _____ in. at _____ $ _____

_____ Meter _____ in. at _____ $ _____

_____ Lead Joints at _____ $ _____

_____ Leadite Joints at _____ $ _____

_____ Hrs. Foreman at _____ $ _____

2¼ Hrs. Chauffeur at 62½ $ 1.41

4¾ Hrs. Tapper at 62½ $ 2.97

19 Hrs. Labor at 45 $ 8.55

_____ Hrs. Labor at _____ $ _____

_____ Hrs. Compressor at _____ $ _____

_____ Compensation Ins. _____ $ .40

_____ Trucking _____ $ 1.—

_____ Builders Use of Water _____ $ _____

_____ $ _____

_____ $ _____

Tap by Hand $ _____

$ 24.03

---

1 3 0 - 1940

St.
~~Pl.~~
Fifth Ave. No. 34

Name of Owner

Labor and Mat'l. Report SEP 2 4 1940 19

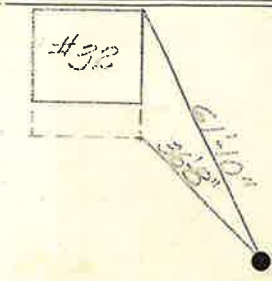

1" Main

Elev. of Main at tap 5'

Gate at ● ● Gate at

● Curb Box

Lot Tap

HH