LABOR AND MATERIALS

1	Copper ~~Lead~~ Connection	3/4"	$ 1.31
1	Curb { Cock ~~Valve~~ ~~T. S. & V.~~ }	3/4 in.	$ 1.75
1	Service Box ~~Old returned~~ { Short 3½x4½ ~~Long 4½x5½~~ ~~Buff. or Rdwy~~ }		$ 1.60
28	Ft. 3/4 in. { Copper ~~Galv. Iron~~ ~~Cast Iron~~ } Pipe at 18		$ 5.04
	Nipples ____ in. at		$
	Bushings ____ to ____ in. at		$
	Red'g Inc'g Couplings ____ to ____ in. at		$
	Union ____ in. at		$
	Meter ____ in. at		$
	Lead Joints at		$
	Leadite Joints at		$
	Hrs. Foreman at		$
2¼	Hrs. Chauffeur at	62½	$ 1.41
1 3/4	Hrs. Tapper at		$ 2.97
19	Hrs. Labor at	45	$ 8.55
	Hrs. Labor at		$
	Hrs. Compressor at		$
	Compensation Ins.		$ .40
	Trucking		$ 1.—
	Builders Use of Water hopatch		$
	P. Parent		$
			$
Taft & Hazell			$
			$24.03

1 2 1 – 1940

Fifth St. ~~Pl.~~ Ave. No. 4

Name of Owner

Torriault

Labor and Mat'l. Report SEP 2 4 1940 19

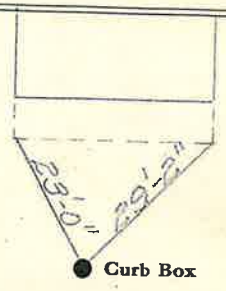

4" Main

Elev. of Main at tap 8'

Gate at ●

● Gate at

● Curb Box

Old tap shut off.