LABOR AND MATERIALS

1	Copper / ~~Lead~~ Connection 3/4	$ 1.78
1	Curb { Clock / ~~Valve~~ / ~~T. S. & V.~~ } 3/4 in.	$ 2.61
1	Service box Old returned { Short 3½X4½ / ~~Long 4½X5½~~ / ~~Buff or Rdway~~ }	$ 1.82
23	Ft. 3/4 in. { Copper / ~~Galv. Iron~~ / ~~Cast Iron~~ } Pipe at 23	$ 5.29
	Nipples ... in. at	$
	Bushings ... to ... in. at	$
	Red'g / Inc'g } Couplings ... to ... in. at	$
	Union ... in. at	$
	Meter ... in. at	$
	Lead Joints at	$
	Compound Joints at	$
	Hrs. Foreman at	$
	Hrs. Chauffeur at	$
3	Hrs. Tapper at 82½	$ 2.48
	Hrs. Labor at	$
6	Hrs. Labor at 71½	$ 4.29
	Hrs. Compressor at	$
	Compensation Ins.	$ 19
	Trucking	$ 1.00
	Builders Use of Water	$
	Copy Mazuna	$
		$
		$
		$
		$ 19.41

87-46

Fifth St. / ~~Pl.~~ / ~~Ave.~~ No. 63

Name of Owner

Shappy Kane

Labor and Mat'l. Report Oct 28 1946

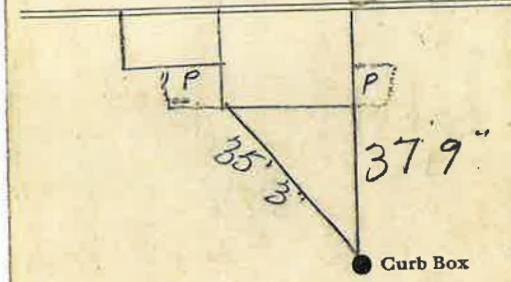

6 Main

Elev. of Main at tap 5

Gate at

Gate at

TAX ID # 309.11-12-28

Curb Box

LBM-5C-6-1-45