LABOR AND MATERIALS

1	Copper / ~~Lead~~ Connection	3/4	$ 2.94
1	Curb — Cock / Valve / T. S. & V.	3/4 in.	$ 3.71
1	Service box Old returned — Short 3½X4½ / Long 4½X5½ / Buff or Rdway		$ 5.90
8	Ft. 3/4 in. — Copper / G. I. / C. I. — Pipe at 30		$ 2.40
	Nipples ... in. at		$
	Bushings ... to ... in. at		$
	Red'g Inc'g Coupl'gs ... to ... in. at		$
	Union ... in. at		$
	Meter ... in. at		$
	Lead Joints at		$
	Compound Joints at		$
1	Hrs. Water Maint. Man—1 at	1.17½	$ 1.17.50
6	Hrs. Water Maint. Man—2 at	1.01½	$ 6.07.50
6	Hrs. Labor— ... at	91	$ 5.46
	Hrs. Labor— ... at		$
	Hrs. Compressor at		$
	Compensation Ins. at $ 2.20 per C		$
	Trucking		$ 1.00
	Pav't Patch		$ 8.30
	Tap 4 Mg 11184		$
			$
			$
	O'head		$
			$ 37.85

156 New 70

Fifth St. / ~~Pl.~~ Ave. No. ~~52~~

Name of Owner

Trimbey

Labor and Mat'l. Report Nov 22 1948

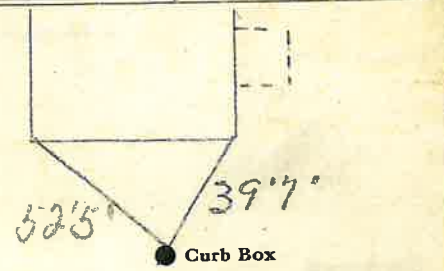

6 Main

Elev. of Main at tap 5

Gate at ● ● Gate at

● Curb Box

L&M-5C 5 15-48