LABOR AND MATERIALS

1	Copper / ~~Lead~~ Connection	3/4"	$ 2.29
1	Curb { Cock / ~~Valve~~ / ~~T. S. & V.~~ }	3/4 in.	$ 2.70
1	Service box / ~~Old returned~~ { Short 3½x4½ / ~~Long 4½x5½~~ / Buff or ~~Rdway~~ }		$ 4.25
11	Ft. 3/4 in. { Copper / ~~G. I.~~ / ~~C. I.~~ } Pipe at 35		$ 3.85
	Nipples ____ in. at ____		$
	Bushings ____ to ____ in. at ____		$
	Red'g / Inc'g { Coupl'gs ____ to ____ in. at ____		$
	Union ____ in. at ____		$
	Meter ____ in. at ____		$
	Lead Joints at ____		$
	Compound Joints at ____		$ 3.86
	Hrs. Water Maint. Man—1 at ____		$
2	Hrs. Water Maint. Man—2 at	1.02	$ 2.04
2	Hrs. Labor— ____ at	91	$ 1.82
	Hrs. Labor— ____ at ____		$
	Hrs. Compressor at ____		$
	Compensation Ins. at $ ____ per C.		$ .09
	Trucking		$ 1.—
	Pav't Patch		$ —
	Tap by Maguire		$
			$
			$
	O'head		$
			$ 18.04

~~132-1950~~

St. / ~~Pl.~~ Fifth Ave. No. 76

Name of Owner

Trimbey

Labor and Mat'l. Report July 19 1950

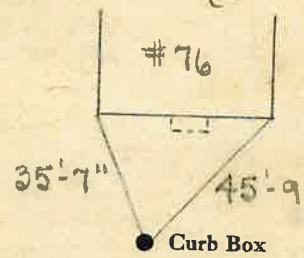

6" Main

Elev. of Main at tap 5'

Gate at ●

● Gate at

● Curb Box

LSM-5C 10-21-49