LABOR AND MATERIALS

1	Copper / ~~Lead~~ Connection 3/4	$ 2.29
1	Curb { Cock / Valve / T. S. & V. } 3/4 in.	$ 2.70
1	Service box / ~~Old returned~~ { Short 3½x4½ / Long 4½x5½ / Buff or Rdway }	$ 4.25
12	Ft. 3/4 in. { Copper / ~~G. I.~~ / ~~C. I.~~ } Pipe at 35	$ 4.20
	Nipples in. at	$
	Bushings to in. at	$
	Red'g / Inc'g { Coupl'gs to in. at	$
	Union in. at	$
	Meter in. at	$
	Lead Joints at	$
	Compound Joints at	$
1	Hrs. Water Maint. Man—1 at 1.12	$ 1.12
3	Hrs. Water Maint. Man—2 at 1.02	$ 3.06
14	Hrs. Labor— at 91	$ 12.74
	Hrs. Labor— at	$
	Hrs. Compressor at	$
	Compensation Ins. at $ per C.	$ .38
	Trucking	$ 1.—
	Pav't Patch	$ —
15¼	Macadam	$
		$
		$
	O'head	$
		$ 31.74

33-1950

Lot 12

St. Fifth Pl. Ave. No. ~~80~~ 82

Name of Owner

Trimbley

Labor and Mat'l. Report June 6 1950

~~82~~ Cor. ~~80~~ Park

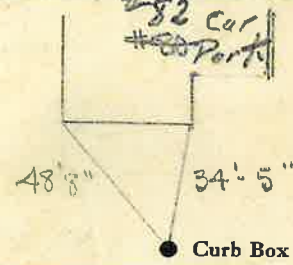

6 Main

Elev. of Main at tap 5

Gate at ●

● Gate at

● Curb Box

LSM-5C 10-21-49