LABOR AND MATERIALS

1	Copper / ~~Lead~~ Connection 3/4	$ 3.05
1	Curb { Cock / Valve / ~~T. S. & V.~~ } 3/4 in.	$ 3.54
1	Service box / ~~Old returned~~ { Short 3½x4½ / ~~Long 4½x5½~~ / Buff or Rdway }	$ 4.70
12	Ft. 3/4 in. { Copper / ~~G. I.~~ / ~~C. I.~~ } Pipe at 35	$ 4.20
	Nipples ____ in. at ____	$
	Bushings ____ to ____ in. at ____	$
	Red'g / Inc'g { Coupl'gs ____ to ____ in. at ____	$
	Union ____ in. at ____	$
	Meter ____ in. at ____	$
	Lead Joints at ____	$
	Compound Joints at ____	$
	Hrs. Water Maint. Man—1 at ____	$
3	Hrs. Water Maint. Man—2 at 113	$ 339
3	Hrs. Labor ~~2~~ at 102	$ 306
	Hrs. Labor— ____ at ____	$
	Hrs. Compressor at ____	$
	Compensation Ins. at $ 266 per C.	$ 17
	Trucking	$ 1.17
	Pav't Patch	$ —
	Tap by Moquin	$
		$
		$
	O'head	$
		$ 23.10

Fifth St. ~~Pl.~~ Ave. No. 84

Name of Owner Trimbey

Labor and Mat'l. Report Dec 12 1950

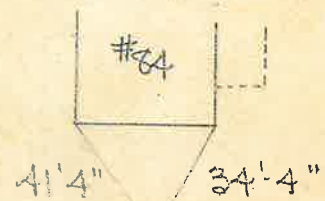

● Curb Box

6" Main

Elev. of Main at tap 5'

Gate at ●

● Gate at

● Curb Box

LSM-5C 10-21-49