LABOR AND MATERIALS

1	Copper ~~Lead~~ Connection	3/4	$1.31
1	Curb { Cock ~~Valve~~ ~~T. S. & V.~~ }	3/4 in.	$1.75
1	Service Box Old returned { ~~Short 3½x4½~~ Long 4½x5½ ~~Buff. or Rdway~~ }		$1.60
12	Ft. 3/4 in. { Copper ~~Galv Iron~~ ~~Cast Iron~~ } Pipe at 18		$2.16
	Nipples ____ in. at		$
	Bushings ____ to ____ in. at		$
	Red'g / Inc'g Couplings ____ to ____ in. at		$
	Union ____ in. at		$
	Meter ____ in. at		$
	Lead Joints at		$
	Leadite Joints at		$
	Hrs. Foreman at		$
	Hrs. Chauffeur at		$
6	Hrs. Tapper at	62½	$ 3.75
6	Hrs. Labor at	45	$ 2.70
	Hrs. Labor at		$
3	Hrs. Compressor at	62½	$ 1.88
	Compensation Ins.		$ .20
	Trucking		$ 1.—
	Builders Use of Water	Patch	$ .50
Tap by Hessel			$
			$
			$
			$
			$ 21.35

19 0 -- 1940

St. / ~~Pl.~~ / ~~Ave.~~ First No. 28

Name of Owner

Trupp

Labor and Mat'l. Report Feb 6 1940

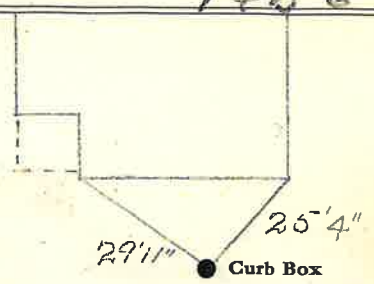

6 Main

Elev. of Main at tap 5

Gate at ● ● Gate at

● Curb Box

REVERSE STOP - "OFF POSITION" IS ON