LABOR AND MATERIALS

1	Copper ~~Lead~~ Connection	3/4	$ 1.35
1	Curb { Cock ~~Valve~~ ~~T. S. & V.~~ }	3/4 in.	$ 1.88
1	Service Box Old returned { Short 3½x4½ ~~Long 4½x5½~~ ~~Buff. or Rdway~~ }		$ 1.82
19	Ft. 3/4 in. { Copper ~~Galv. Iron~~ ~~Cast Iron~~ } Pipe at 20		$ 3.80
	Nipples in. at		$
	Bushings to in. at		$
	Red'g Inc'g Couplings to in. at		$
	Union in. at		$
	Meter in. at		$
	Lead Joints at		$
	Leadite Joints at		$
	Hrs. Foreman at		$
6	Hrs. Chauffeur at	68¾	$ 4.12
6	Hrs. Tapper at	68¾	$ 4.13
	Hrs. Labor at		$
	Hrs. Labor at		$
1	Hrs. Compressor at	92	$ .92
	Compensation Ins.		$ 26
	Trucking		$ 1.—
	Builders Use of Water Patch		$ 5.—
	Taylor Works		$
			$
			$
			$
			$ 24.28

H.

2 5 1942

St. Pl. First Ave. No. 30

Name of Owner

Taylor

Labor and Mat'l. Report True 3 19 42

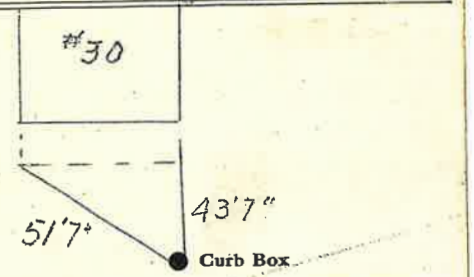

6 Main

Elev. of Main at tap 91

Gate at ● ● Gate at

TX ID # 309.12-7-7

● Curb Box

H.