LABOR AND MATERIALS

1	Copper Lead — Connection	3/4"	$1.23
1	Curb — Cock / Valve / T. S. & V.	3/4 in.	$1.68
1	Service Box Old returned — Short 3½x4½ / Long 4½x5½ / Buff. or Rdway		$1.54
11	Ft. 3/4 in. — Copper / Galv. Iron / Cast Iron Pipe at 17		$1.87
	Nipples ____ in. at		$
	Bushings ____ to ____ in. at		$
	Red'g / Inc'g Couplings ____ to ____ in. at		$
	Union ____ in. at		$
	Meter ____ in. at		$
	Lead Joints at		$
	Leadite Joints at		$
	Hrs. Foreman at		$
4	Hrs. Chauffeur at	62½	$2.50
	Hrs. Tapper at		$
8	Hrs. Labor at	.45	$3.60
	Hrs. Labor at		$
1	Hrs. Compressor at	.65	$.65
	Compensation Ins.		$.19
	Trucking		$1.—
	Builders Use of Water	Patch	$.5—
	Tap by Penn		$
			$
			$
			$
			$19.26

4 8 - - 1939

St. / Pl. First Ave. No. 34

Name of Owner

Dietrich

Labor and Mat'l. Report July 25 1939

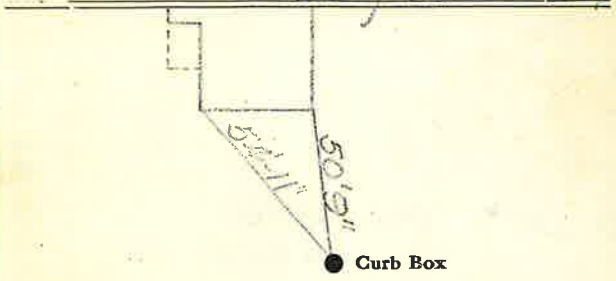

6" Main — Elev. of Main at tap 4'

Gate at ● ● Gate at

● Curb Box

Old tap disconnected.