LABOR AND MATERIALS

1 Copper ~~Lead~~ } Connection 3/4 $ _____

1 Curb { Cock ~~Valve~~ ~~T.C. & V.~~ } 3/4 in. _____ $ _____

1 Service box Old returned { Short 3-1/2 x 4-1/2 ~~Long 4-1/2 x 6-1/2~~ } _____ $ _____

11 Ft. 3/4 in. { Copper ~~Wrt.~~ ~~Cast.~~ } Pipe at _____ $ _____

_____ Nipples _____ in. at _____ $ _____

1 Bushings 1/2 to 3/4 in. at _____ $ _____

_____ Red'g

_____ Inc'g

_____ Union _____ in. at _____ $ _____

_____ Meter _____ in. at _____ $ _____

_____ _____ $ _____

_____ Compound Joints at _____ $ _____

_____ Maintenance Foreman _____ $ _____

_____ Hrs. Water Maint. Man - 1 at _____ $ _____

_____ Hrs. Water Maint. Man - 2 at _____ $ _____

_____ Hrs. Garage Foreman _____ at _____ $ _____

_____ Hrs. Labor _____ at _____ $ _____

_____ Hrs. Compressor at _____ $ _____

_____ _____ $ _____

_____ Trucking _____ $ _____

_____ Pav't Patch _____ $ _____

_____ _____ $ _____

_____ _____ $ _____

_____ _____ $ _____

_____ _____ $ _____

$ _____

FIRST St. ~~Ave.~~ No. 36

Name of Owner

Labor and Mat'l. Report ~~Job~~ JUNE 17, 1930

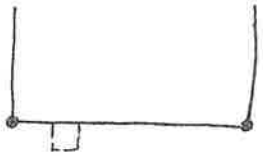

31-7 25-7

● Curb Box

6" Main Elev. of Main at tap 5'

Gate at ● ● Gate at

● Curb Box

OLD TAP DISCONNECTED