Labor and Materials

1 ~~Copper~~ Lead } Connection 3/4 ..... $.....

1 Curb { ~~Cock~~ Valve ~~T. S. & V.~~ } 1" in ..... $.....

1 Service Box Old returned { Short 3½ x 4½ ~~Long 4½ x 6½~~ ~~Ruff. cor. Rdway~~ } ..... $.....

22 Ft. 1" in. { ~~Copper~~ Galv Iron ~~Cast-Iron~~ } Pipe at ..... $.....

..... Nipples ..... in. at ..... $.....

..... Bushings ..... to ..... in. at ..... $.....

Red'g Inc'g } Couplings ..... to ..... in. at ..... $.....

..... Union ..... in. at ..... $.....

..... Meter ..... in. at ..... $.....

..... Lead Joints at ..... $.....

..... Leadite Joints at ..... $.....

..... Hrs. Foreman at ..... $.....

..... Hrs. Chauffeur at ..... $.....

..... Hrs. Tapper at ..... $.....

..... Hrs. Labor at ..... $.....

..... Hrs. Labor at ..... $.....

..... Hrs. Compressor at ..... $.....

..... Compensation Ins. ..... $.....

..... Trucking ..... $.....

..... Builders Use of Water ..... $.....

..... $.....

..... $.....

..... $.....

..... $.....

$.....

First St. ~~Pl.~~ ~~Ave.~~ No. 5-7

Name of Owner

M. J. Drucker

Labor and Mat'l. Report 7/8 1922

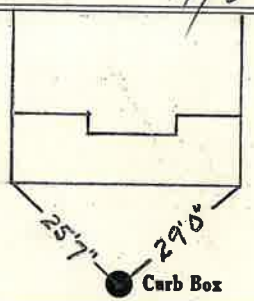

..... Main Elev. of Main at tap ....

Gate at ● ● Gate at

● Curb Box

Shutoff at curb
April 18 - 1923