LABOR AND MATERIALS

1	Copper Lead — Connection	3/4"	$ 2.29
1	Curb — Cock / Valve / ~~T. S. & V.~~	3/4" in.	$ 2.70
1	Service box — ~~Old~~ returned — ~~Short 3½x4½~~ / Long 4½x5½ / ~~Buff or Rdway~~		$ 4.25
26	Ft. 3/4 in. — Copper / ~~G. I.~~ / ~~C. I.~~ — Pipe at 35		$ 9.10
	Nipples in. at		$
	Bushings to in. at		$
	Red'g / Inc'g — Coupl'gs to in. at		$
	Union in. at		$
	Meter in. at		$ .94
	Lead Joints at		$ .24
	Compound Joints at		$
3	Hrs. Water Maint. Man—1 at	1.12	$ 3.36
6	Hrs. Water Maint. Man—2 at	1.02	$ 6.12
16	Hrs. Labor— at	91	$ 14.56
	Hrs. Labor— at		$
1/2	Hrs. Compressor at	1.20	$ .60
	Compensation Ins. at $ per C.		$ .54
	Trucking		$ 1.—
	Pav't Patch B. P.		$
			$
			$
			$
	O'head		$
			$44.57

Before Paving

1949-1950

St.
~~Pl.~~
Ave. No. 41

First

Name of Owner

G. A. & Helen Hosler

Labor and Mat'l. Report July 21 1950

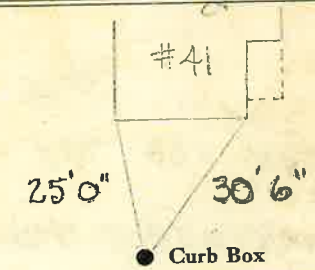

6" Main

Elev. of Main at tap 5'

Gate at ●

● Gate at

Copper
25' Left
30'6" Right

LSM-5C 10-21-49