LABOR AND MATERIALS

1 Copper (Lead) Connection	3/4	$1.31
1 Curb (Cock / Valve / T. S. & V.)	3/4 in.	$1.75
1 Service Box Old returned (Short 3½x4½ / Long 4½x5½ / Buff. or Rdway)		$1.60
13 Ft. 3/4 in. (Copper / Galv Iron / Cast Iron) Pipe at 18		$2.34
____ Nipples ____ in. at		$
____ Bushings ____ to ____ in. at		$
____ Red'g Inc'g Couplings ____ to ____ in. at		$
____ Union ____ in. at		$
____ Meter ____ in. at		$
____ Lead Joints at		$
____ Leadite Joints at		$
____ Hrs. Foreman at		$
3 Hrs. Chauffeur at 62½		$1.88
1 Hrs. Tapper at		$3.75
6 Hrs. Labor at 45		$2.70
____ Hrs. Labor at		$
____ Hrs. Compressor at		$
____ Compensation Ins.		$.126
____ Trucking		$1.—
____ Builders Use of Water Patch		$5.—
Tapby Hessel		$
		$
		$
		$
		$21.59

2 6 - - 1940

St. First Pl. Ave. No. 44

Name of Owner

Grout

Labor and Mat'l. Report May 24 1940

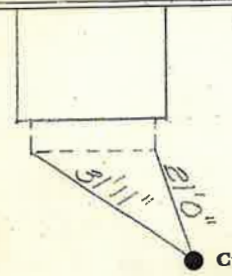

6 Main — Elev. of Main at tap 6

Gate at ● — ● Gate at

TAX ID # 309.12-7-14

● Curb Box