LABOR AND MATERIALS

1	Copper / ~~Lead~~ Connection 3/4	$ 1.23
1	Curb { Cock / ~~Valve~~ / T. S. & V. } 3/4 in.	$ 1.68
1	Service Box Old returned { ~~Short 3½x4½~~ / Long 4½x5½ / ~~Buff. or Rdway~~ }	$ 1.54
25	Ft. 3/4 in. { Copper / ~~Galv Iron~~ / Cast Iron } Pipe at 17	$ 4.25
	Nipples ____ in. at	$
	Bushings ____ to ____ in. at	$
	Red'g / Inc'g Couplings ____ to ____ in. at	$
	Union ____ in. at	$
	Meter ____ in. at	$
	Lead Joints at	$
	Leadite Joints at	$
	Hrs. Foreman at	$
3	Hrs. Chauffeur at 62½	$ 1.88
8	Hrs. Tapper at "	$ 5.00
8	Hrs. Labor at .45	$ 3.60
	Hrs. Labor at	$
1	Hrs. Compressor at .65	$ 1.30
	Compensation Ins.	$ .37
	Trucking	$ 1.00
	Builders Use of Water Patch	$ 5.00
	Tap by Hosser	$
		$
		$
		$
		$ 26.80

2 5 - 1939

St. / ~~Pl~~ First Ave. No. 47

Name of Owner

Tokillard

Labor and Mat'l. Report June 1 1939

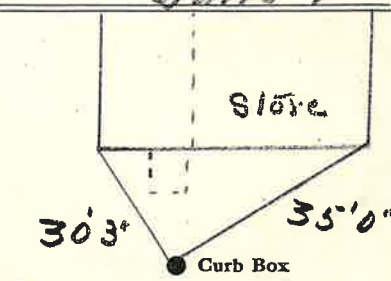

6" Main

Elev. of Main at tap 6'

Gate at ● ● Gate at

● Curb Box

old Haddie be dug up and shut - to be charged.

Tbb