LABOR AND MATERIALS

1	Copper / ~~Lead~~ Connection	3/4"	$ 2.29
1	Curb { Cock / Valve / T. S. & V. }	3/4 in.	$ 2.70
1	Service box Old returned { Short 3½x4½ / ~~Long 4½x5½~~ / Buff or Rdway }		$ 4.25
26	Ft. 3/4 in. { Copper / ~~G. I.~~ / ~~C. I.~~ } Pipe at 35		$ 9.10
	Nipples in. at		$
	Bushings to in. at		$
	Red'g / Inc'g Coupl'gs to in. at		$
	Union in. at		$
	Meter in. at		$
	Lead Joints at		$ 2.40
	Compound Joints at		$
3	Hrs. Water Maint. Man—1 at	1.12	$ 3.36
6	Hrs. Water Maint. Man—2 at	1.02	$ 6.12
16	Hrs. Labor— at	91	$ 14.56
	Hrs. Labor— at		$
	Hrs. Compressor at		$
	Compensation Ins. at $ per C.		$ .54
	Trucking		$
	Pav't Patch 15 P.		$
			$
			$
			$
	O'head		$
			$ 43.92

161-1950 Before Paving

✓

St. / ~~Pl.~~ First Ave. No. 49

Name of Owner

S. Aaronson

Labor and Mat'l. Report July 21 1950

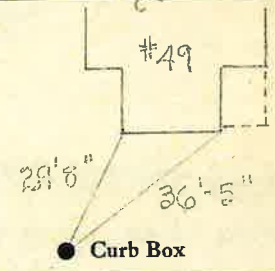

6" Main

Elev. of Main at tap 5'

Gate at ●

● Gate at

● Curb Box

LSM-5C 10-21-49