Labor and Materials

1	Lead Connection 1"	$ 3.75
1	Curb Cock 1"	$ 2.50
1	Service Box { ~~Short 3½ x 4~~ / ~~Long 4½ x 5½~~ / ~~Old round~~ / Buffalo }	$ 1.00
22	Ft. 1 in. G. I. Pipe at	$ 2.64
	Nipples in. at	$
	Bushings in. at	$
	Red'g Coup to in. at	$
	Inc'g Coup to in. at	$
	Union in. at	$
	Meter in. at	$
	Cu. Yds. Br. Stone at	$
	Cu. Yds. Sand at	$
	Bags Cement at	$
	Pav. Brick { Mack / Red / Asphalt } at	$
7	Hrs. Foreman at	$ 3.06
7	Hrs. Com. Labor at	$ 2.19
	Hrs. Mason at	$
	Hrs. at	$
	Hrs. at	$
	Builders' Use of Water	$
	at	$
	at	$
	at	$
	at	$

aug 7 Total $ 15.14

Labor and Material Report Aug 7 1914

1" tap at No 9 First St-

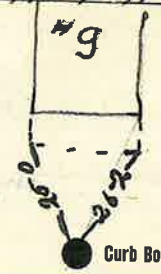

6" Main Elev. of Main at tap 5½

Gate at ● ● Gate at

● Curb Box

Shut off - At Curb
1-8-1973