LABOR AND MATERIALS

1	Copper Lead — Connection	3/4	$ 2.94
1	Curb — Cock / ~~Valve~~ / ~~T. S. & V.~~	3/4 in.	$ 3.71
1	Service box — Old returned — Short 3½X4½ / ~~Long 4½X5½~~ / ~~Buff or Rdway~~		$ 5.90
8	Ft. 3/4 in. — ~~Copper~~ / ~~G. I.~~ / ~~C. I.~~ Pipe at 30		$ 2.40
	Nipples ... in. at		$
	Bushings ... to ... in. at		$
	Red'g / Inc'g Coupl'gs ... to ... in. at		$
	Union ... in. at		$
	Meter ... in. at		$
	Lead Joints at		$
	Compound Joints at		$
2	Hrs. Water Maint. Man—1 at	1.12	$ 2.24
	Hrs. Water Maint. Man—2 at		$
12	Hrs. Labor— ... at	91	$ 10.92
	Hrs. Labor— ... at		$
	Hrs. Compressor at		$
	Compensation Ins. at $ ... per C		$ .29
	Trucking		$ 1.00
	Pav't Patch		$ 6.70
	Typ 4 Miller		$
			$
			$
	O'head		$
			$ 36.10

92

St.
Pl.
Flandreaux Ave. No. 10

Name of Owner

Smith

Labor and Mat'l. Report July 20 1948

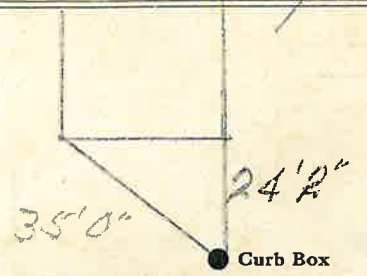

4 Main — Elev. of Main at tap 4

Gate at ● — ● Gate at

● Curb Box

LSM-5C 5 15-48