LABOR AND MATERIALS

1	Copper / ~~Lead~~ Connection	3/4"	$ 2.76
1	Curb — Cock / ~~Valve~~ / ~~T. S. & V.~~	3/4 in.	$ 3.49
1	Service box — ~~Old returned~~ — Short 3½X4½ / ~~Long 4½X5½~~ / ~~Buff or Rdway~~		$ 4.75
27	Ft. 3/4 in. — Copper / ~~G. I.~~ / ~~C. I.~~	Pipe at 35	$ 9.45
	Nipples ... in. at		$
	Bushings ... to ... in. at		$
	Red'g / Inc'g Coupl'gs ... to ... in. at		$
	Union ... in. at		$
	Meter ... in. at		$
	Lead Joints at		$
	Compound Joints at		$
2	Hrs. Water Maint. Man—1 at		$
2	Hrs. Water Maint. Man—2 at	1.24	$ 2.48
2	Hrs. Labor— ... at	1.13	$ 2.26
	Hrs. Labor— ... at		$
	Hrs. Compressor at		$
	Compensation Ins. at $3.706 per C		$ .18
	Trucking		$
	Pav't Patch ... outside		$ 1.00
	Tap by Gleason-d 6-11-52		$
			$
	O'head		$
			$ 26.37

Lift- .80

25.57

N. G. F.

~~St.~~ Pl. Ave. No. 38 Fort Amherst Rd.

Name of Owner

Hough

Labor and Mat'l. Report JUNE 11 1952

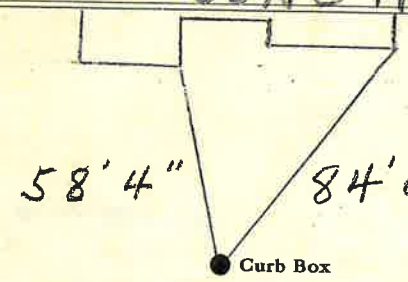

6" Main

Elev. of Main at tap 5½'

Gate at ● ● Gate at

● Curb Box

LSM-SC 5 15-48