LABOR AND MATERIALS

1	Copper / ~~Lead~~ Connection 3/4	$ 2.87
1	Curb { Cock / ~~Valve~~ / ~~T. S. & V.~~ } 3/4 in.	$ 3.62
1	Service box / ~~Old returned~~ { ~~Short 3½X4½~~ / Long 4½X5½ / Buff or Rdway }	$ 4.68
25	Ft. 3/4 in. { Copper / ~~G. I.~~ / ~~C. I.~~ } Pipe at 32	$ 8.00
	Nipples ..... in. at	$
	Bushings ..... to ..... in. at	$
	Red'g / Inc'g Coupl'gs ..... to ..... in. at	$
	Union ..... in. at	$
	Meter ..... in. at	$
	Lead Joints at	$
	Compound Joints at	$
4	Hrs. Water Maint. Man—1 at 1.12	$ 4.48
	Hrs. Water Maint. Man—2 at	$
4	Hrs. Labor— ....at .91	$ 3.64
	Hrs. Labor— ....at	$
	Hrs. Compressor at	$
	Compensation Ins. at $ 2.18 per C	$ 18
	Trucking	$ 2.00
	Pav't Patch	$ —
	Tap by Magnum	$
		$
		$
	O'head	$
		$ 29.47

164
No Glens Falls

Fort Amherst St. Pl. Ave. No. 44

Name of Owner

L. Calkins

Labor and Mat'l. Report Dec 4 1998

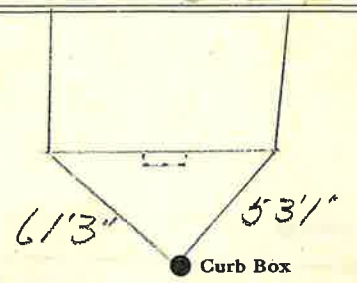

6 Main Elev. of Main at tap 8

Gate at ● ● Gate at

● Curb Box

LSM-5C 5 15-48