LABOR AND MATERIALS

1	Copper { ~~Lead~~ } Connection	3/4"	$ 2.76
1	Curb { Cock ~~Valve~~ ~~T. S. & V.~~ }	3/4 in.	$ 3.49
1	Service box { Short 3½X4½ ~~Long 4½X5½~~ ~~Buff or Rdway~~ } Old returned		$ 4.74
10	Ft. 3/4 in. { Copper ~~G. I.~~ ~~C. I.~~ } Pipe at 38		$ 3.80
	Nipples ... in. at		$
	Bushings ... to ... in. at		$
	Red'g Inc'g { Coupl'gs ... to ... in. at		$
	Union ... in. at		$
	Meter ... in. at		$
	Lead Joints at		$ 16.04
	Compound Joints at		$
	Hrs. Water Maint. Man—1 at ...		$
2	Hrs. Water Maint. Man—2 at	1.24	$ 2.48
12	Hrs. Labor— ... at	1.13	$ 13.56
	Hrs. Labor— ... at		$
	Hrs. Compressor at		$
	Compensation Ins. at $4.06 per C		$ .71
	Trucking		$ 1.00
	Pav't Patch		$
Tap by Gifford 4-14-53			$
			$
			$
	O'head		$
			$ 32.54

32.54

11-53

Ft. Amherst Rd. St. Pl. Ave. No. 53-55

Name of Owner Corner Edison Rd.

~~Raymond J. Selleck~~

Labor and Mat'l. Report April 14 1953

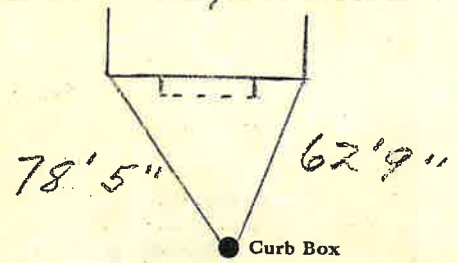

6" Main

Elev. of Main at tap 4 1/2

Gate at ● ● Gate at

10' to main

● Curb Box

Tap on Ft. Amherst Rd.

Erlanger's

LBM-SC 5 15-48