LABOR AND MATERIALS

1 Copper ~~Lead~~ } Connection 3/4" ____ $____

1 Curb { Cock / ~~Valve~~ / ~~T. S. & V.~~ } 3/4 in. ____ $____

1 Service Box Old returned { Short 3½x4½ / Long 4½x5½ / ~~Buff. or Rdway~~ } ____ $____

26 Ft. 3/4 in. { Copper / ~~Galv Iron~~ / ~~Cast Iron~~ } Pipe at ____ $____

____ Nipples ____ in. at ____ $____

____ Bushings ____ to ____ in. at ____ $____

1 ~~Red'g~~ / ~~Inc'g~~ } Couplings 3/4 to ____ in. at 3-Piece Coup. $____

____ Union ____ in. at Near Main. $____

____ Meter ____ in. at ____ $____

____ Lead Joints at ____ $____

____ Leadite Joints at ____ $____

____ Hrs. Foreman at ____ $____

____ Hrs. Chauffeur at ____ $____

____ Hrs. Tapper at ____ $____

____ Hrs. Labor at ____ $____

____ Hrs. Labor at ____ $____

____ Hrs. Compressor at ____ $____

____ Compensation Ins. ____ $____

____ Trucking ____ $____

____ Builders Use of Water ____ $____

Dug up at main & ____ $____

repaired by Peck & Co. ____ $____

____ $____

9-16-71. ____ $____

____ $____

Rd.
~~St.~~
~~Pl.~~

Ft. Amherst Ave. No. 6

Name of Owner

~~Ralph Knight~~ Cunningham

Measured

Labor and Mat'l. Report 7-18-39 **19**

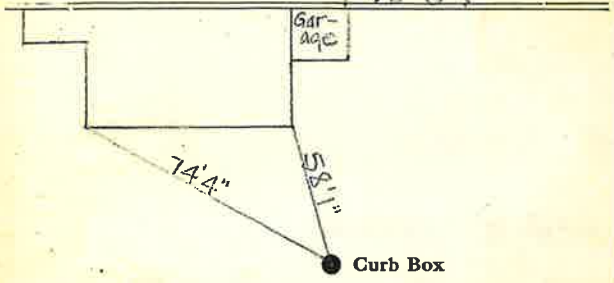

6" Main

Elev. of Main at tap 4'

Gate at ● ● Gate at

● Curb Box