Labor and Materials

1 ~~Copper~~ Lead } Connection 3/4" ..... $.....

1 Curb { ~~Cock~~ Valve T. S. & V. } 1" in ..... $.....

..... Service Box Old returned { Short 3½ x 4½ Long 4½ x 5½ Buff. or Rdway } ..... $.....

8 Ft. 1 in. { ~~Copper~~ Galv Iron Cast Iron } Pipe at ..... $.....

1 Nipples ..... in. at ..... $.....

1 Bushings ..... to ..... in. at ..... $.....

1 Red'g ~~Incr~~ } Couplings ..... to ..... in. at ..... $.....

..... Union ..... in. at ..... $.....

..... Meter ..... in. at ..... $.....

..... Lead Joints at ..... $.....

..... Leadite Joints at ..... $.....

..... Hrs. Foreman at ..... $.....

..... Hrs. Chauffeur at ..... $.....

..... Hrs. Tapper at ..... $.....

..... Hrs. Labor at ..... $.....

..... Hrs. Labor at ..... $.....

..... Hrs. Compressor at ..... $.....

..... Compensation Ins. ..... $.....

..... Trucking ..... $.....

..... Builders Use of Water ..... $.....

..... $.....

..... $.....

..... $.....

..... $.....

$.....

Fourth St. ~~Pl.~~ ~~Ave.~~ No. 15

Name of Owner

Warren W. Smith

Labor and Mat'l. Report Oct. 19 1922

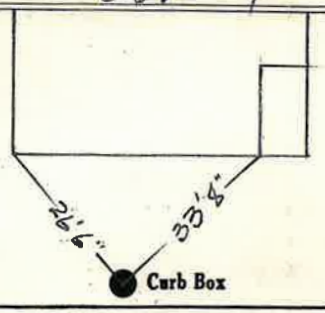

TAX ID # 309.12-13-25

..... Main Elev. of Main at tap ....

Gate at ● ● Gate at

● Curb Box

1" Rensselaer Gate Valve at Curb With Rod. Turn easy till off