LABOR AND MATERIALS

1	Copper ~~Lead~~ Connection	3/4	$ 2.80
1	Curb { Clock ~~Valve~~ ~~T. S. & V.~~ }	3/4 in.	$ 3.60
1	Service box Old returned { ~~Short 3½X4½~~ Long 4½X5½ ~~Buff or Rdway.~~ }		$ 5.80
24	Ft. 3/4 in. { Copper ~~Galv. Iron~~ ~~Cast Iron~~ } Pipe at 35		$ 8.40
	Nipples in. at		$
	Bushings to in. at		$
	Red'g Inc'g Couplings to in. at		$
	Union in. at		$
	Meter in. at		$
	Lead Joints at		$
	Compound Joints at		$
3	Hrs. ~~Foreman at~~ WMM	101	$ 2.02
6	Hrs. Chauffeur at	91	$ 5.46
	Hrs. Tapper at		$
16	Hrs. Labor at	80	$ 12.80
	Hrs. Labor at		$
	Hrs. Compressor at		$
	Compensation Ins.		$ 1.45
	Trucking		$
	Builders Use of Water		$ 9.30
	Tap by Water Service		$
			$
			$
			$
			$ 51.63

47-47

Fourth St. ~~Pl.~~ ~~Ave.~~ No. 4

Name of Owner

Conklin

Labor and Mat'l. Report July 16 1947

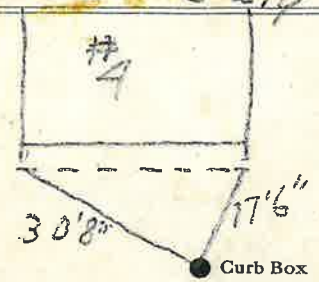

6" Main

Elev. of Main at tap 4'

Gate at

Gate at

Curb Box

LSM-5C-6-1-45