LABOR AND MATERIALS

1 Copper ~~Iron~~	Connection 3/4	$
1 Curb	Cock ~~Valve~~ ~~T. Box & V.~~ 3/4 in.	$
1 Service box ~~Old returned~~	~~Short 3½ x 4½~~ Long 4½ x 5½ ~~Buff or Rdway~~	$
24 Ft. 3/4 in.	Copper ~~Iron~~ Pipe at	$
Nipples	in. at	$
Bushings	to in. at	$
Red'g Inc'g	Coupl'gs to in. at	$
Union	in. at	$
Meter	in. at	$
Lead Joints at		$
Compound Joints at		$
Maintenance Foreman		$
Hrs. Water Maint. Man—1 at		$
Hrs. Water Maint. Man—2 at		$
Hrs. Garage Foreman	at	$
Hrs. Labor—	at	$
Hrs. Compressor at		$
Compensation Ins. at $	per C	$
Trucking		$
Pav't Patch		$
		$
Tap Nov 9, 1978		$
		$
O'head		$
		$

Fourth St. Pl. Ave. No. 25

Name of Owner

James Phillips

Labor and Mat'l. Report Nov. 9, 1980

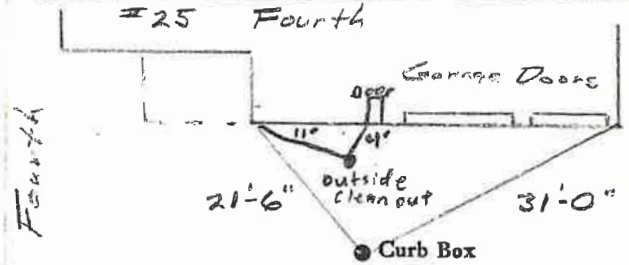

6" Main — Elev. of Main at tap 5'

Gate at ● — ● Gate at

TAX ID # 309.11-11-21

● Curb Box

Tap on Big Cross Street
Outside cleanout is 2'6" from house

LSM—5C—6-1-67