Labor and Materials

Copper Lead } Connection ..... $ .....

Curb { Cock / Valve / T. S. & V. } ..... in .... $ .....

Service Box { Short 3½ x 4½ / Long 4½ x 5½ / Buff. or Rdway } ..... $ .....
Old returned

8 Ft. 3/4" in. { Copper / ~~Galv. Iron~~ / ~~Cast Iron~~ } Pipe at ..... $ .....

Nipples ..... in. at ..... $ .....

Bushings ..... to ..... in. at ..... $ .....

Red'g Inc'g } Couplings ..... to ..... in. at ..... $ .....

Union ..... in. at ..... $ .....

Meter ..... in. at ..... $ .....

Lead Joints at ..... $ .....

Leadite Joints at ..... $ .....

Hrs. Foreman at ..... $ .....

Hrs. Chauffeur at ..... $ .....

Hrs. Tapper at ..... $ .....

Hrs. Labor at ..... $ .....

Hrs. Labor at ..... $ .....

Hrs. Compressor at ..... $ .....

Compensation Ins. ..... $ .....

Trucking ..... $ .....

Builders Use of Water ..... $ .....

..... $ .....

..... $ .....

..... $ .....

..... $ .....

$ .....

FOURTH St. ~~Pl.~~ ~~Ave.~~ No. 27

Name of Owner

Labor and Mat'l. Report May 31 1923

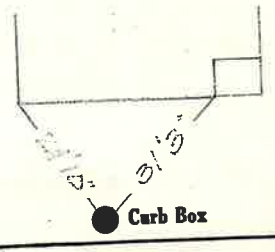

6" Main

Elev. of Main at tap 4'

Gate at 8' to MAIN

● Gate at

● Curb Box