LABOR AND MATERIALS

1 Copper ~~Lead~~ } Connection 3/4 $ _____

1 Curb { Cock ~~Valve~~ ~~T.S. & V.~~ } 3/4 in. _____ $ _____

1 Service box { ~~Short 3-1/2 x 4-1/2~~ Long 4-1/2 x 5-1/2 } _____ $ _____

24 Ft. 3/4 in. { Copper ~~Gl.~~ ~~Cl.~~ } Pipe at _____ $ _____

_____ Nipples _____ in. at _____ $ _____

_____ Bushings _____ to _____ in. at _____ $ _____

_____ Red'g

_____ Inc'g

_____ Union _____ in. at _____ $ _____

_____ Meter _____ in. at _____ $ _____

_____ _____ $ _____

_____ Compound Joints at _____ $ _____

_____ Maintenance Foreman _____ $ _____

_____ Hrs. Water Maint. Man - 1 at _____ $ _____

_____ Hrs. Water Maint. Man - 2 at _____ $ _____

_____ Hrs. Garage Foreman _____ at _____ $ _____

_____ Hrs. Labor _____ at _____ $ _____

_____ Hrs. Compressor at _____ $ _____

_____ _____ $ _____

_____ Trucking _____ $ _____

_____ Pav't Patch _____ $ _____

_____ _____ $ _____

_____ _____ $ _____

_____ _____ $ _____

_____ _____ $ _____

$ _____

FOURTH St. ~~Ave.~~ No. 6

Name of Owner

Labor and Mat'l. Report 1934, OCT. 12

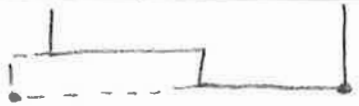

19-6 20-2

● Curb Box

6" Main Elev. of Main at tap 4 1/2'

Gate at ● ● Gate at

TAX ID # 309.12-14-7

● Curb Box

OLD SHUT OFF AT MAIN

ALVAH KINGSLEY