LABOR AND MATERIALS

1	Copper ~~Lead~~ Connection 3/4	$ 1.31
1	Curb {~~Cock~~ ~~Valve~~ ~~T. S. & V.~~} 3/4 in.	$ 1.75
1	Service Box Old returned {~~Short 3½x4½~~ ~~Long 4½x5½~~ ~~Buff. or Rdway~~}	$ 1.60
9	Ft. 3/4 in. {Copper ~~Galv Iron~~ ~~Cast Iron~~} Pipe at 18	$ 1.62
	Nipples ____ in. at	$
	Bushings ____ to ____ in. at	$
	Red'g Inc'g Couplings ____ to ____ in. at	$
	Union ____ in. at	$
	Meter ____ in. at	$
	Lead Joints at	$
	Leadite Joints at	$
	Hrs. Foreman at	$
	Hrs. Chauffeur at	$
14	Hrs. Tapper at 62½	$ .16
34½	Hrs. Labor at 45	$ 1.58
	Hrs. Labor at	$
	Hrs. Compressor at	$
	Compensation Ins.	$ 06
	Trucking	$ 1.—
	Builders Use of Water Before Paving	$ —
	Tap by Hand.	$
		$
		$
		$ 9.08

5 0 - - 1940

St. Pl. Fourth Ave. No. 62

Name of Owner

Frank Thomas Est. 2" Tap

Labor and Mat'l. Report June 12 1940

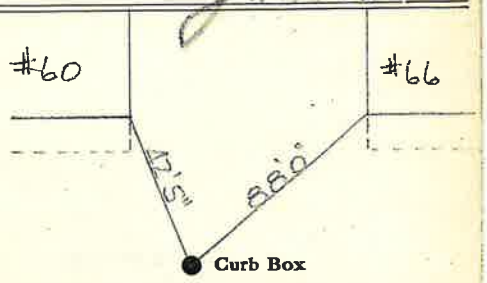

6 Main

Elev. of Main at tap 42

Gate at ● ● Gate at

● Curb Box