LABOR AND MATERIALS

1	Copper ~~Lead~~ Connection	3/4	$ 1.23
1	Curb { Cock / ~~Valve~~ / ~~T. S. & V.~~ }	3/4 in.	$ 1.68
1	Service Box ~~Old returned~~ { Short 3½x4½ / ~~Long 4½x5½~~ / ~~Buff. or Rdway~~ }		$ 1.75
29	Ft. 3/4 in. { Copper / ~~Galv Iron~~ / ~~Cast Iron~~ } Pipe at 15		$ 4.35
	Nipples in. at		$
	Bushings to in. at		$
	Red'g / Inc'g Couplings to in. at		$
	Union in. at		$
	Meter in. at		$
	Lead Joints at		$
	Leadite Joints at		$
	Hrs. Foreman at		$
1	Hrs. Chauffeur at 62½		$ 2.50
1	Hrs. Tapper at "		$ 2.50
6	Hrs. Labor at 45		$ 3.60
	Hrs. Labor at		$
	Hrs. Compressor at		$
	Compensation Ins.		$ .26
	Trucking		$ 1.00
	Builders Use of Water ½ Patch (Sewer)		$ 2.50
Taphy Penor			$
			$
			$
			$
			$ 21.37

1 0 5 - 1938

St. Pl. 63 Fourth Ave. No. 63

Name of Owner

Edward Ball

Labor and Mat'l. Report Sept 17 1938

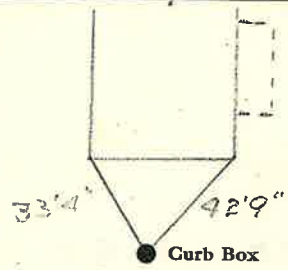

6 Main

Elev. of Main at tap 4½

Gate at ● ● Gate at

● Curb Box

New House.