LABOR AND MATERIALS

1	Copper Lead — Connection 3/4	$ 1.31
1	Curb — Cock / ~~Valve~~ / ~~T. S. & V.~~ — 3/4 in.	$ 1.75
1	Service Box ~~Old returned~~ — Short 3½x4½ / Long 4½x5½ / ~~Buff. or Rdway~~	$ 1.60
9	Ft. 3/4 in. — ~~Copper~~ / ~~Galv Iron~~ / Cast Iron — Pipe at 18	$ 1.62½
	Nipples ____ in. at	$
	Bushings ____ to ____ in. at	$
	Red'g / Inc'g — Couplings ____ to ____ in. at	$
	Union ____ in. at	$
	Meter ____ in. at	$
	Lead Joints at	$
	Leadite Joints at	$
	Hrs. Foreman at	$
	Hrs. Chauffeur at	$
1/4	Hrs. Tapper at 67½	$ .16
3½	Hrs. Labor at 45	$ 1.58
	Hrs. Labor at	$
	Hrs. Compressor at	$
	Compensation Ins.	$ .06
	Trucking	$ 1.—
	Builders Use of Water Before Paving	$ —
	Tap by Hassel	$
		$
		$
		$
		$ 9.08

5 1 - - 1940

St. ~~Pl.~~ ~~Ave.~~ Fourth No. 64

Name of Owner

Frank Thomas Est hot Tap

Labor and Mat'l. Report June 12 1940

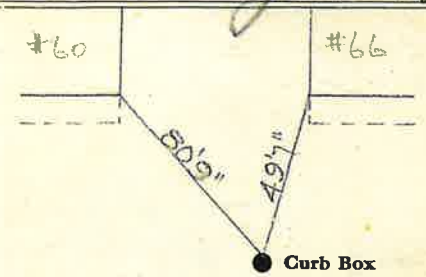

6 Main — Elev. of Main at tap 4½

Gate at ● — ● Gate at

● Curb Box