LABOR AND MATERIALS

1	Copper / ~~Lead~~ Connection	3/4	$ 1.31
1	Curb { Cock / Valve / T. S. & V. }	3/4 in.	$ 1.75
1	Service Box Old returned { ~~Short 3½x4½~~ / Long 4½x5½ / ~~Buff. or Rdway~~ }		$ 1.60
5½	Ft. 3/4 in. { Copper / ~~Galv Iron~~ / ~~Cast Iron~~ }	Pipe at 18	$ .99
	Nipples ____ in. at		$
	Bushings ____ to ____ in. at		$
	Red'g / Inc'g Couplings ____ to ____ in. at		$
	Union ____ in. at		$
	Meter ____ in. at		$
	Lead Joints at		$
	Leadite Joints at		$
	Hrs. Foreman at		$
3	Hrs. Chauffeur at .62½		$ 1.88
	Hrs. Tapper at		$
4	Hrs. Labor at .45		$ 1.80
	Hrs. Labor at		$
	Hrs. Compressor at		$
	Compensation Ins.		$ .12
	Trucking		$ 1.—
	Builders Use of Water no Patch		$ —
	Tapped Mueller Ext.		$
			$
			$
			$
			$ 10.45

1 0 1 - 1940

St. ~~Pl.~~ Now 74

Fourth Ave. No. ~~68~~

Name of Owner

Thomas (Lot Tap)

Labor and Mat'l. Report Aug 20 19 40

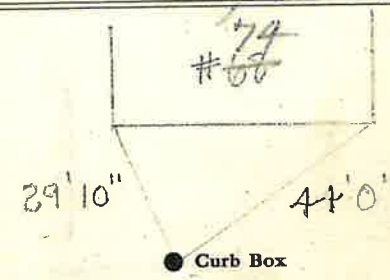

6 Main

Elev. of Main at tap 5

Gate at ● ● Gate at

Curb Box

Hydrant

N.

LABOR AND MATERIALS

1	Copper ~~Lead~~ Connection	3/4	$ 1.31
1	Curb Cock ~~Valve~~ ~~T. S. & V.~~	3/4 in.	$ 1.75
1	Service Box ~~Old returned~~ Short 3½x4½ / Long 4½x5½ / Buff. or Rdway		$ 1.60
9	Ft. 3/4 in. Copper ~~Galv Iron~~ ~~Cast Iron~~ Pipe at 18		$ 1.62
	Nipples ____ in. at		$
	Bushings ____ to ____ in. at		$
	Red'g / Inc'g Couplings ____ to ____ in. at		$
	Union ____ in. at		$
	Meter ____ in. at		$
	Lead Joints at		$
	Leadite Joints at		$
	Hrs. Foreman at		$
	Hrs. Chauffeur at		$
1/4	Hrs. Tapper at	62½	$ .16
3½	Hrs. Labor at	45	$ 1.58
	Hrs. Labor at		$
	Hrs. Compressor at		$
	Compensation Ins.		$ 06
	Trucking		$ 1.—
	Builders Use of Water	no patch	$
	Tap by Hessel Before Pav		$
			$
			$
			$
			$ 9.08

5 6 - - 1940

St. ~~Pl.~~ ~~Ave.~~ No. 74 ?

Fourth

Name of Owner

Frank Thomas Est. Lot tap

Labor and Mat'l. Report June 14 1940

N

● Curb Box

6" Main

Elev. of Main at tap 4½

Gate at ●

● Gate at

123'

● Curb Box

Hydrant