LABOR AND MATERIALS

1 Copper ~~Lead~~ Connection	3/4	$ 1.31
1 Curb { Cock ~~Valve~~ ~~T. C. & V.~~ }	3/4 in.	$ 1.75
1 Service Box Old ~~returned~~ { ~~Short 3½x4½~~ Long 4½x5½ Buff. or Rdway }		$ 1.60
9 Ft. 3/4 in. { Copper Galv Iron ~~Cast Iron~~ } Pipe at 18		$ 1.62
____ Nipples ____ in. at		$
____ Bushings ____ to ____ in. at		$
____ Red'g Inc'g } Couplings ____ to ____ in. at		$
____ Union ____ in. at		$
____ Meter ____ in. at		$
____ Lead Joints at		$
____ Leadite Joints at		$
____ Hrs. Foreman at		$
____ Hrs. Chauffeur at		$
1/4 Hrs. Tapper at .62½		$ .16
2½ Hrs. Labor at .45		$ 1.58
____ Hrs. Labor at		$
____ Hrs. Compressor at		$
____ Compensation Ins.		$ .06
____ Trucking		$ 1.—
____ Builders Use of Water Before Paving		$
Tap by Hassel		$
		$
		$
		$ 9.08

52 – 1940

Now #76 #78

St. ~~Pl.~~ Ave. No. 40

Fourth

Name of Owner

Frank Thomas Est. Hot Tap

Labor and Mat'l. Report June 14 1940

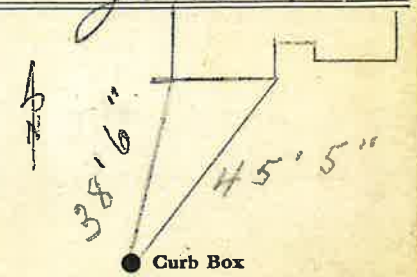

6 Main

Elev. of Main at tap 4½

Gate at ● ● Gate at

9' to main

● Curb Box

28