LABOR AND MATERIALS

1	Copper / Lead — Connection	3/4	$ 1.31
1	Curb — Cock / ~~Valve~~ / T. S. & V.	3/4 in.	$ 1.75
1	Service Box — Old returned — Short 3½x4½ / Long 4½x5½ / Buff. or Rdway		$ 1.60
25 Ft. 3/4 in.	Copper / Galv Iron / Cast Iron — Pipe at	18	$ 4.50
	Nipples ____ in. at		$
	Bushings ____ to ____ in. at		$
	Red'g / Inc'g — Couplings ____ to ____ in. at		$
	Union ____ in. at		$
	Meter ____ in. at		$
	Lead Joints at		$
	Leadite Joints at		$
	Hrs. Foreman at		$
	Hrs. Chauffeur at		$
2 1/2	Hrs. Tapper at	62½	$ 1.44
9	Hrs. Labor at	45	$ 4.05
	Hrs. Labor at		$
	Hrs. Compressor at		$
	Compensation Ins.		$ .14
	Trucking		$ 1.-
	Builders Use of Water Before Paving		$
	Tap by Hessel		$
			$
			$
			$
			$ 14.79

5 5 - - 1940

St. ~~Pl.~~ 81 89

Fourth Ave. No. 93-75

Name of Owner

Edward Ball Lot

Labor and Mat'l. Report June 14 1940

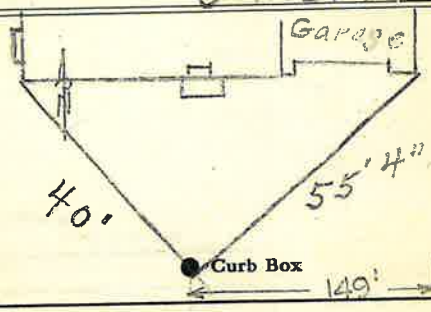

6 Main

Elev. of Main at tap 4'

Gate at ●

● Gate at

Fourth

● Curb Box